



POOR LEGIBILITY

ONE OR MORE PAGES IN THIS DOCUMENT ARE DIFFICULT TO READ
DUE TO THE QUALITY OF THE ORIGINAL



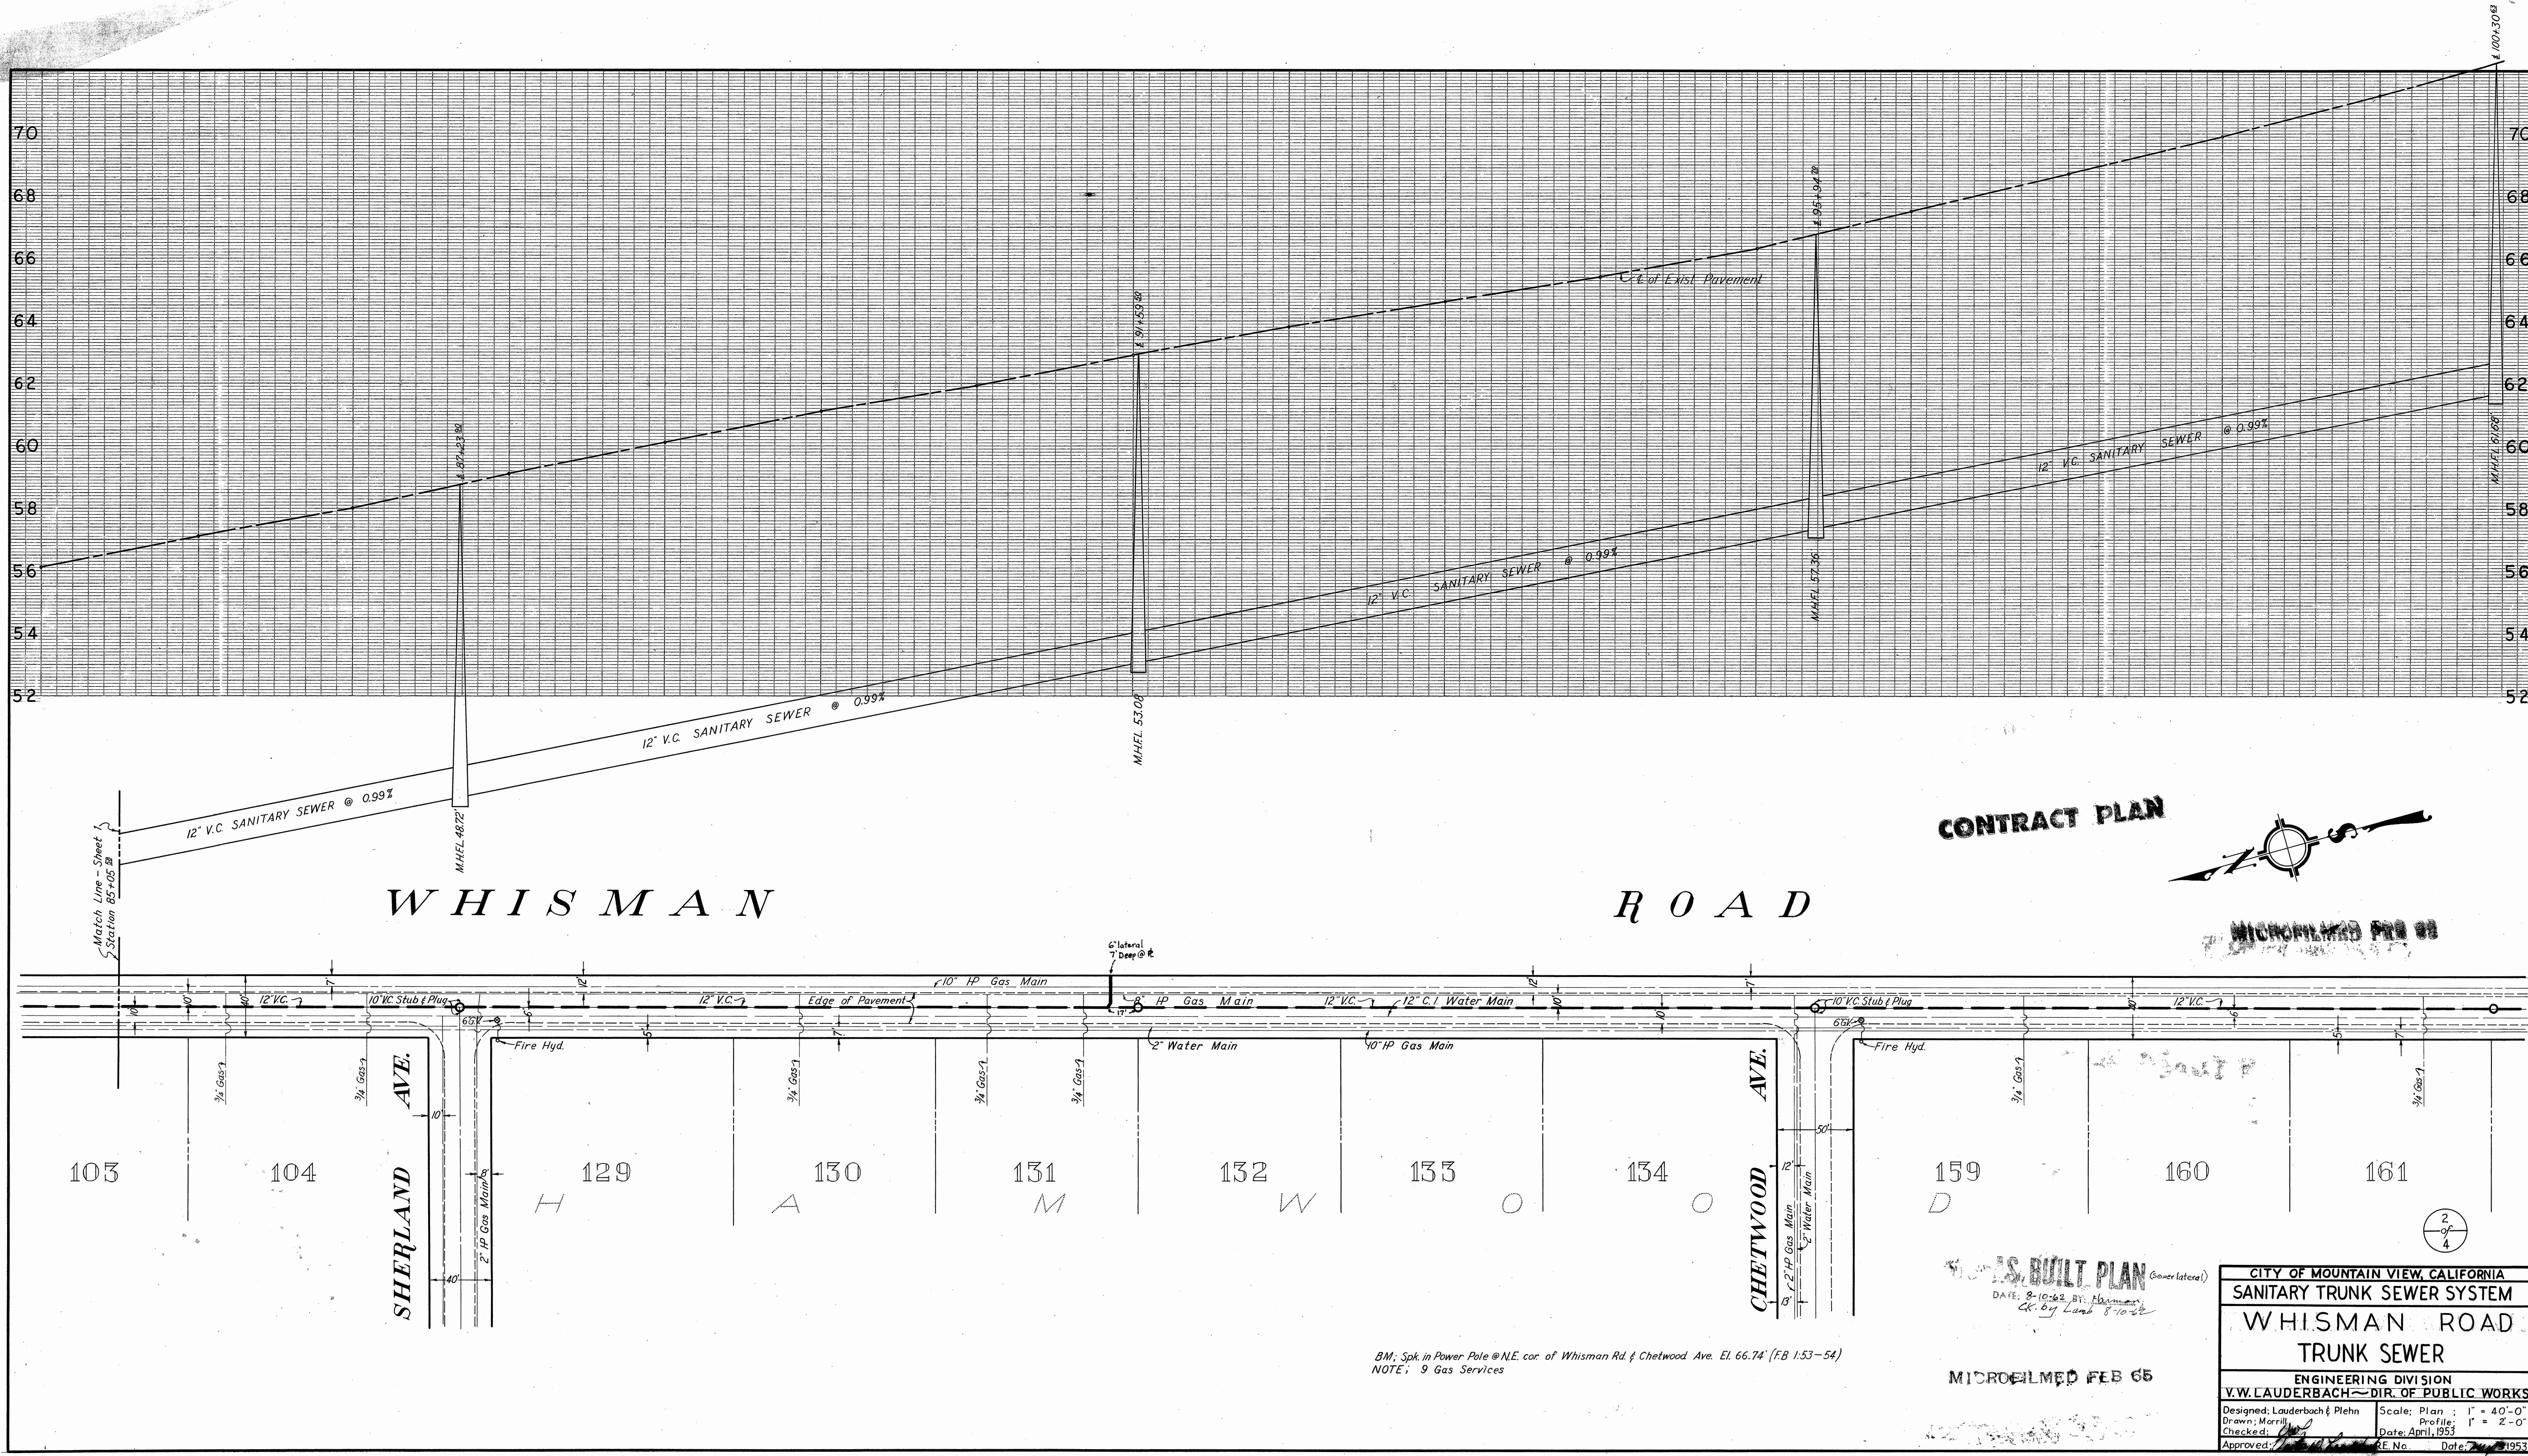

CONTRACT PLAN

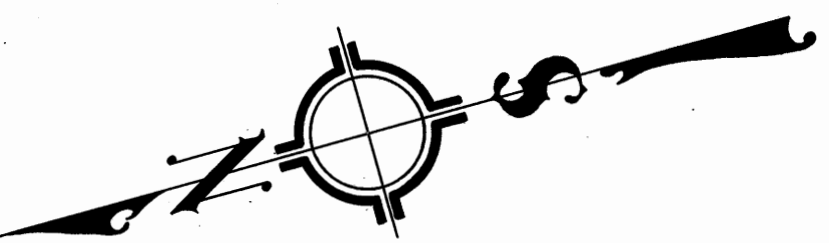


MICROFILMED FEB 66

AS BUILT PLAN
DATE: 8-10-62 BY: [Signature]
K. G. Lamb 8-10-62

MICROFILMED FEB 66

BM: Spk. in Power Pole @ NE. cor. of Whisman Rd. & Chetwood Ave. El. 66.74' (FB 1:53-54)
NOTE: 9 Gas Services

CITY OF MOUNTAIN VIEW, CALIFORNIA	
SANITARY TRUNK SEWER SYSTEM	
WHISMAN ROAD	
TRUNK SEWER	
ENGINEERING DIVISION	
V.W. LAUDERBACH - DIR. OF PUBLIC WORKS	
Designed: Lauderbach & Plehn	Scale: Plan: 1" = 40'-0"
Drawn: Merrill	Profile: 1" = 2'-0"
Checked: [Signature]	Date: April, 1953
Approved: [Signature]	RE No. [Blank] Date: [Blank] 1953

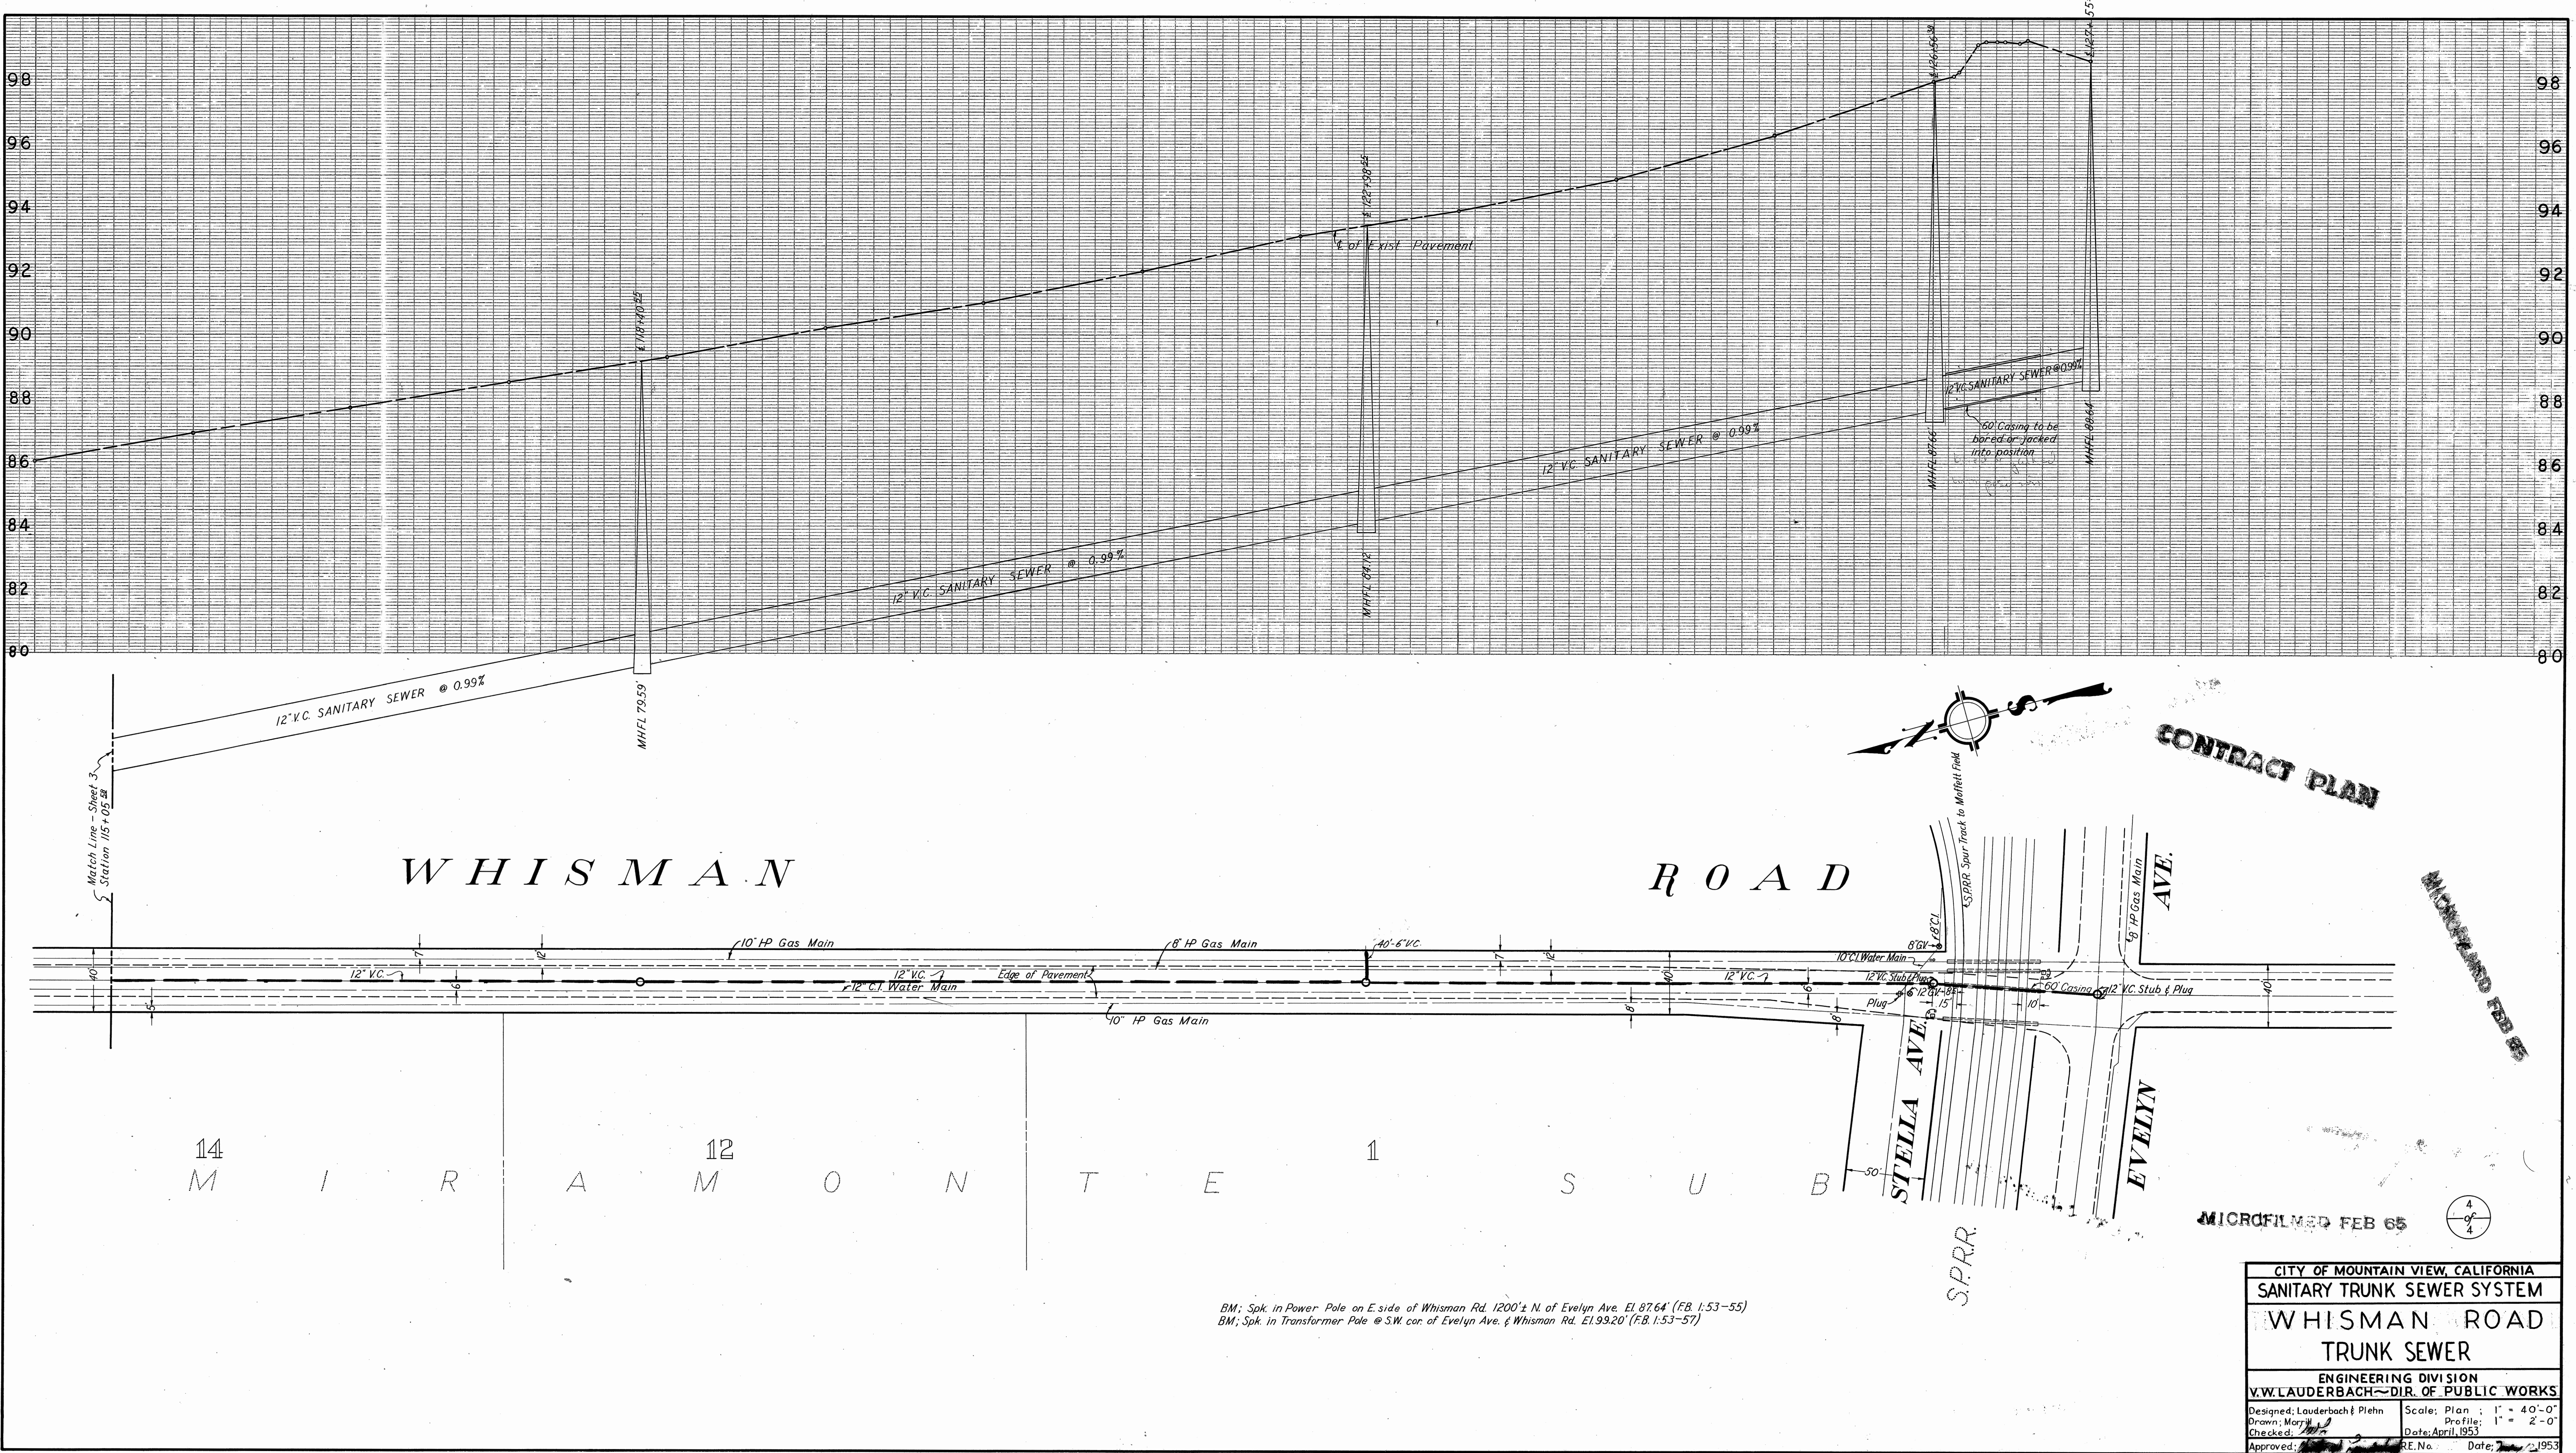

BM; Spk. in Power Pole on E. side of Whisman Rd. 1200'± N. of Evelyn Ave. El. 87.64' (FB. 1:53-55)
BM; Spk. in Transformer Pole @ S.W. cor. of Evelyn Ave. & Whisman Rd. El. 99.20' (FB. 1:53-57)

MICROFILMED FEB 65

CITY OF MOUNTAIN VIEW, CALIFORNIA	
SANITARY TRUNK SEWER SYSTEM	
WHISMAN ROAD	
TRUNK SEWER	
ENGINEERING DIVISION	
V.W. LAUDERBACH - DIR. OF PUBLIC WORKS	
Designed: Lauderbach & Plehn	Scale: Plan : 1" = 40'-0"
Drawn: Moriyu	Profile: 1" = 2'-0"
Checked: [Signature]	Date: April, 1953
Approved: [Signature]	Date: [Signature] 1953